

6000 Fairview

6000 Fairview
Charlotte, NC

SouthPark Towers



Level
Three

As-built

November 9, 2015

Not to Scale

CBRE
CB RICHARD ELLIS

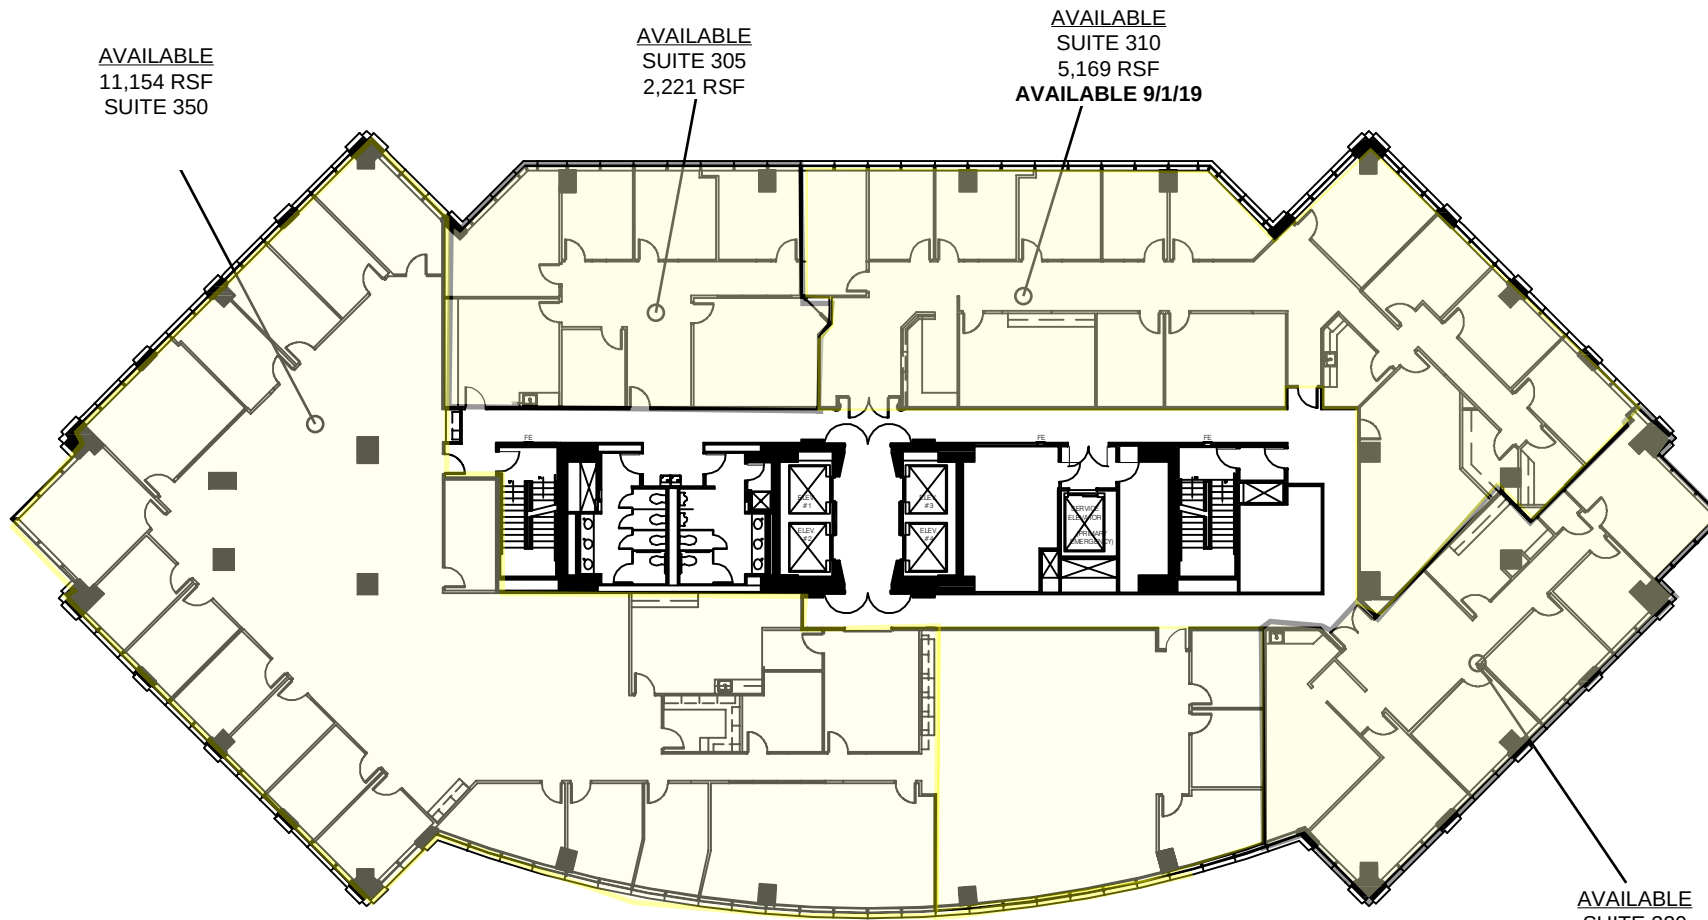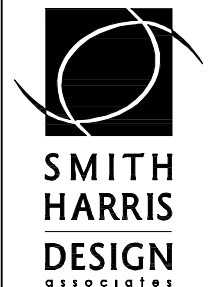

LEASING INFORMATION
ANNE VULCANO
704.331.1244
anne.vulcano@cbre.com

21,136 RSF TOTAL